SEWER HOUSE CONNECTION AS CONSTRUCTED

KOPPS ROAD
STAGE 3
OXENFORD

SHEET 1 of 1

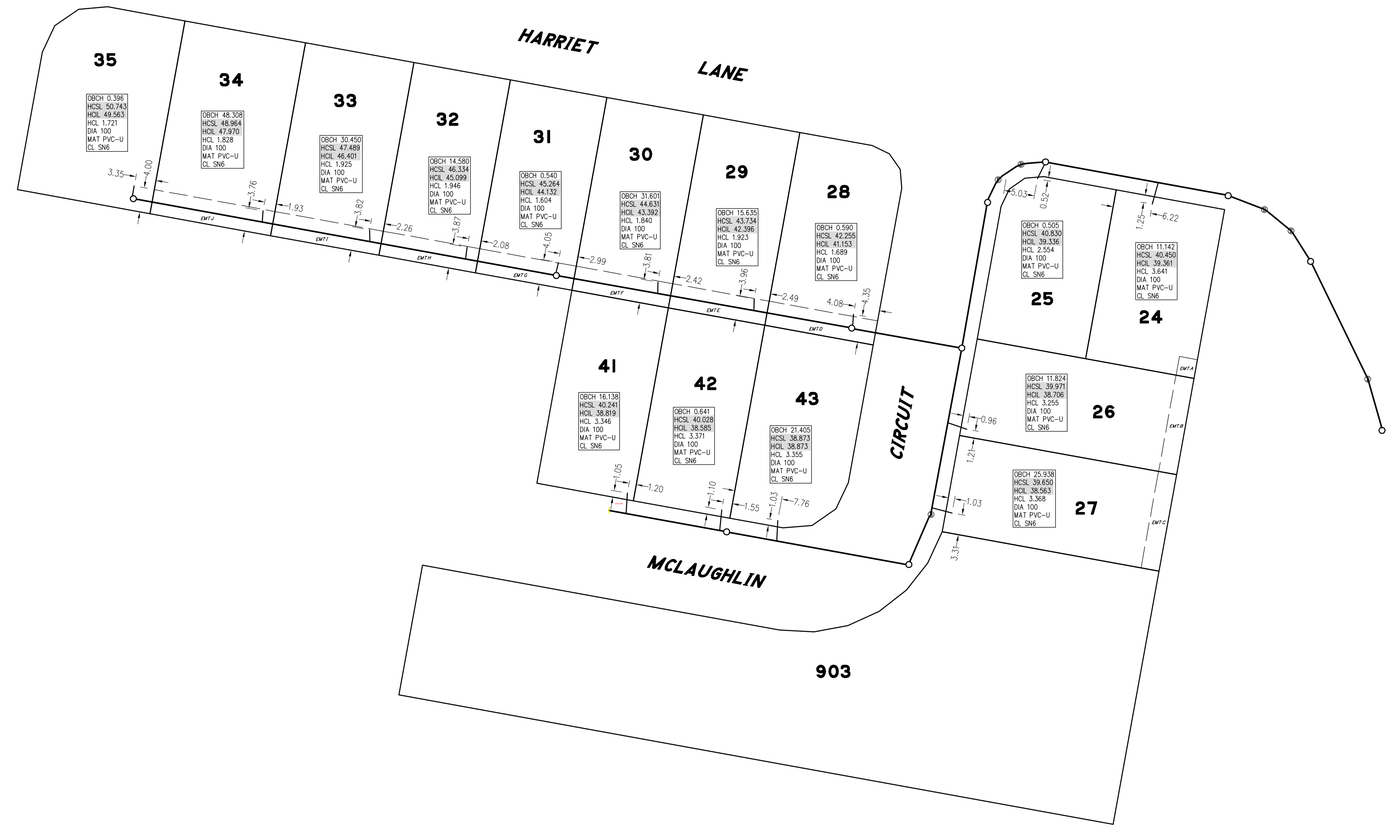

N

Consulting Engineer's Certification:

1. I state that the works described on this drawing have been constructed under my supervision, and I or my authorised representatives have inspected the works at all stages of construction.
2. I certify that the works have been constructed to my satisfaction and in accordance with the development approval, the approved drawings and any relevant planning scheme policies and standard specifications.
3. I certify that the approved drawings have been carefully compared with the works site as to line, levels and dimensions, and this drawing has been accurately amended in all respects as to constitute a true record of the works.

Signed

Registered Surveyor's Certification:

I, .Scott Nind ...hereby certify that the vertical and horizontal locations, and dimensions shown on this plan are a true and correct record of the As Constructed information.

Signed

Authorised Delegate
RPS

Scale 1:500@A1 – Lengths are in Metres.

5 0 5 10 15 20 25 30 35 40 45 50 55 60 65 70